




Engineering & Surveying Consultants
LB 7464
7659 Southwest 102nd Place
Miami, Florida 33173
Tel. 305-215-3280
305-606-0031
Fax. 305-412-3545

**FINAL AS-BUILT
FAMILY DOLLAR REPAIR STORE
SECTION 15, TOWNSHIP 52 SOUTH, RANGE 41 EAST**

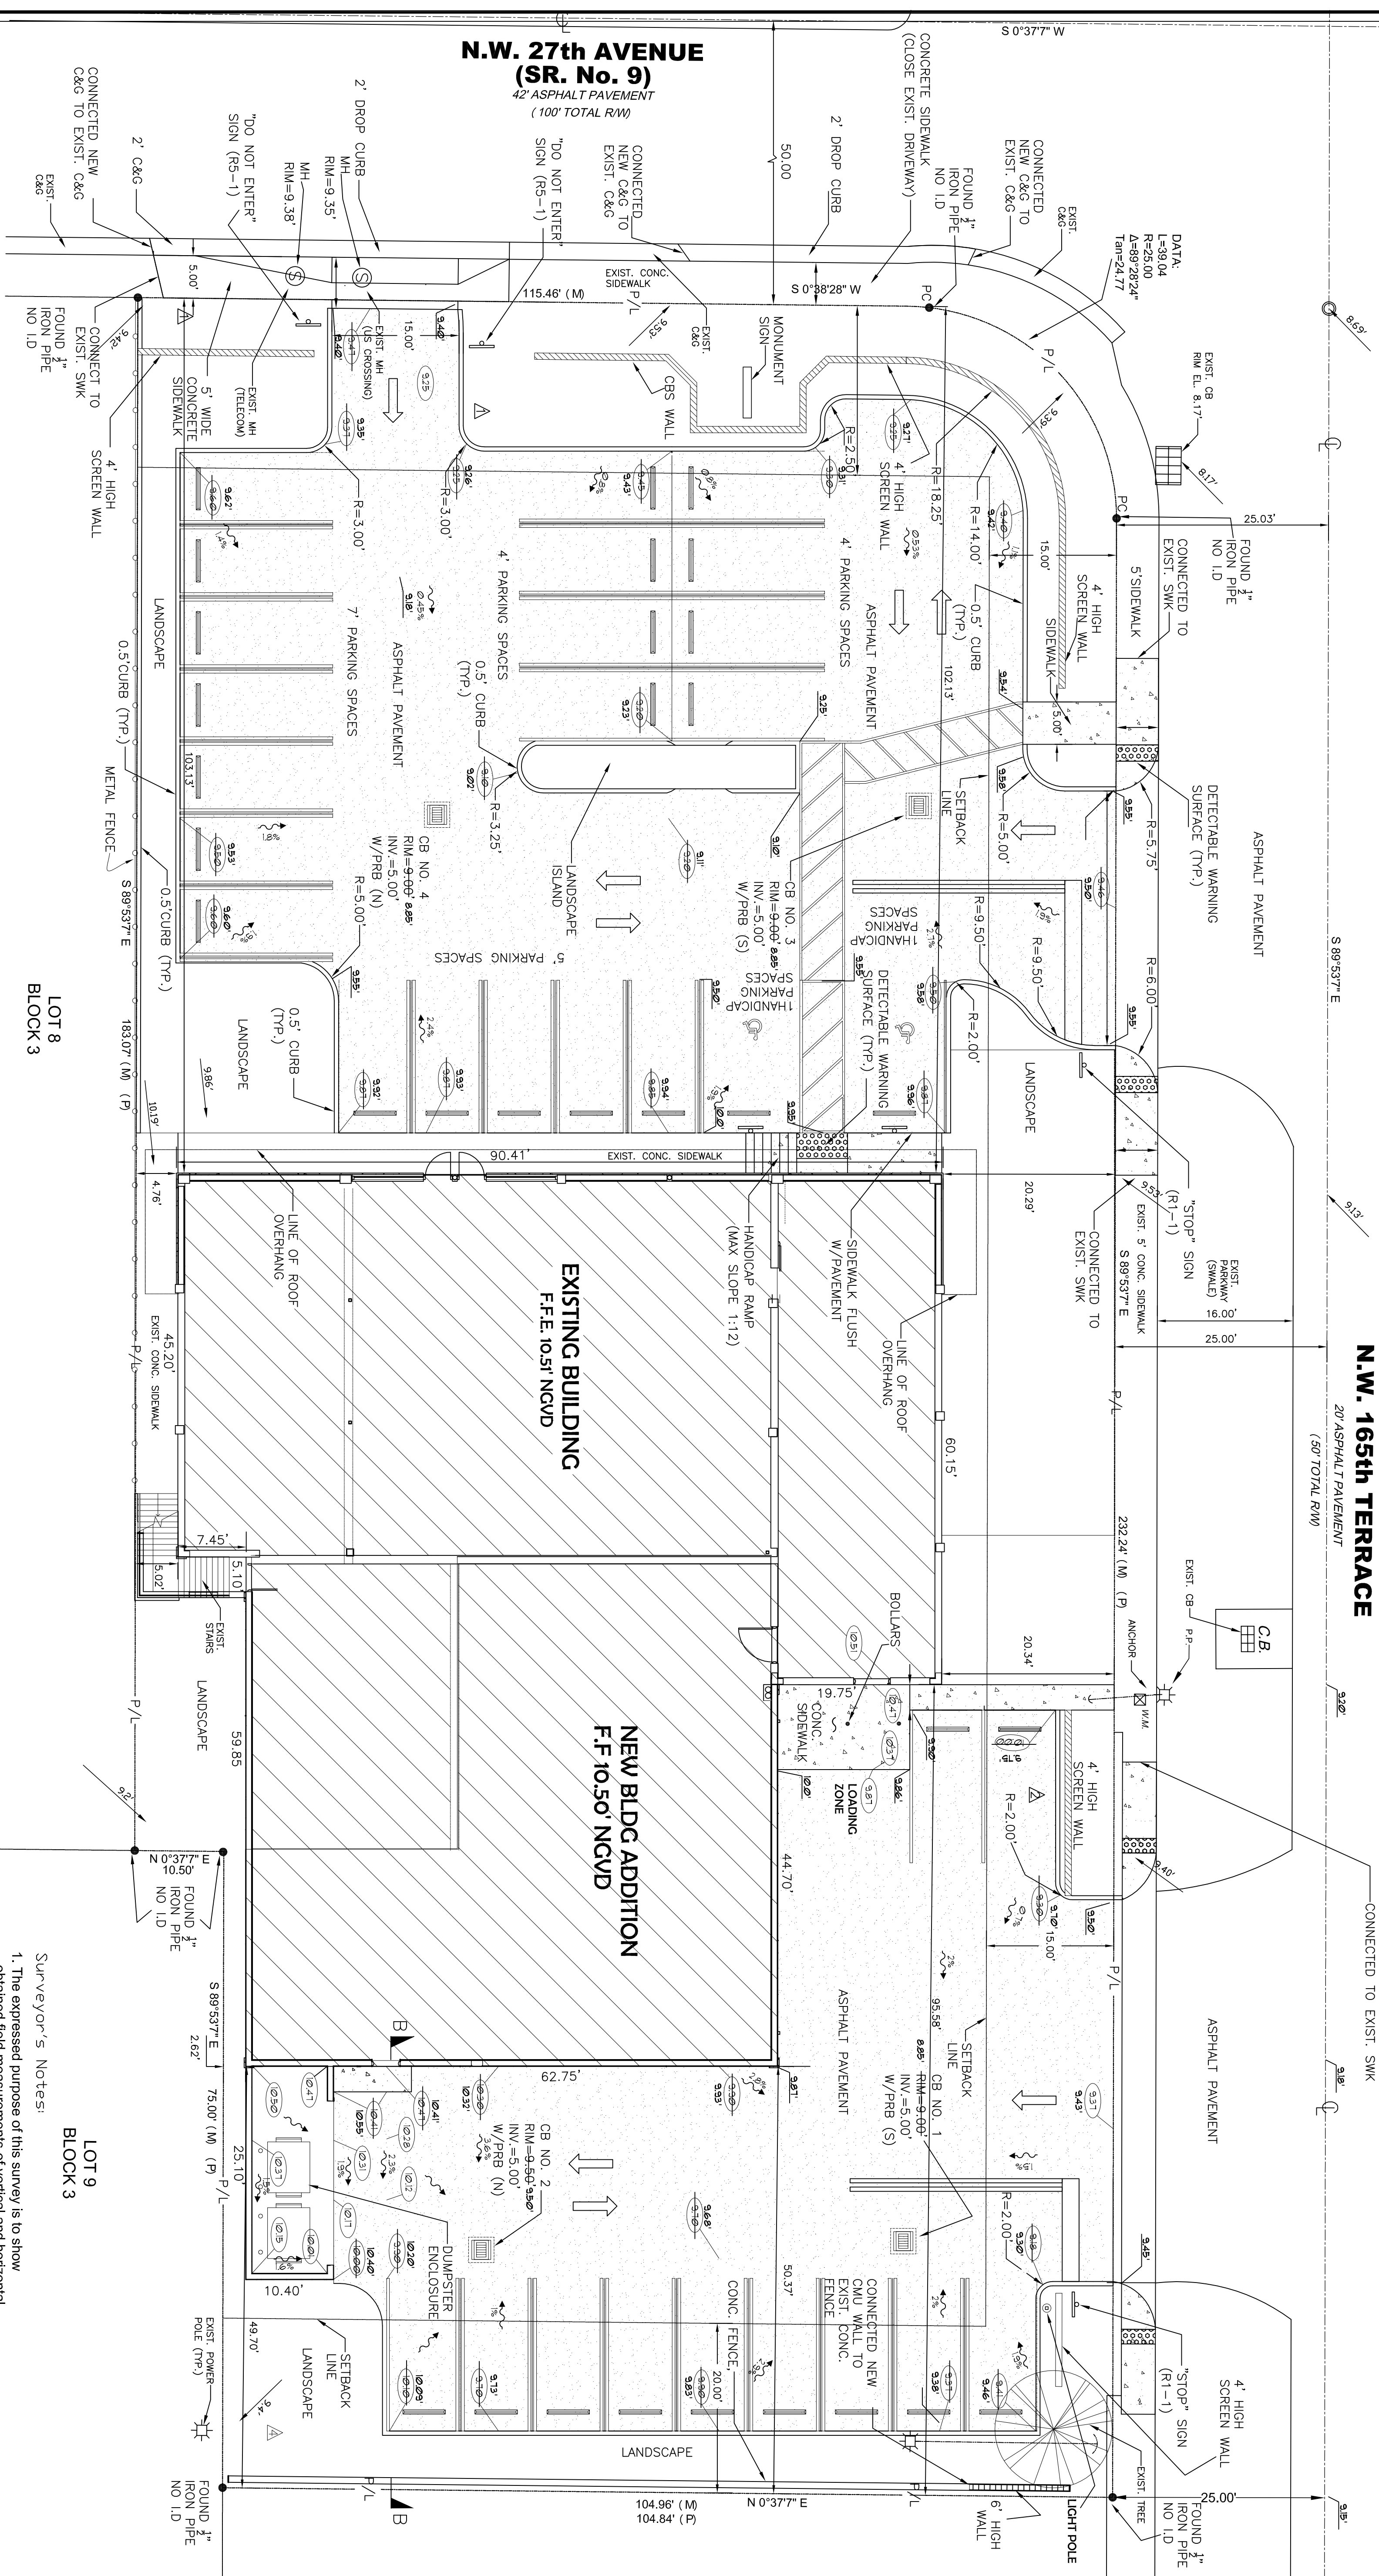

LOCATION SKETCH N.T.S

PROPERTY ADDRESS
16525-16537 N.W. 27th AVENUE
MIAMI , FLORIDA 33147

LOCATION SITE

Not valid without the signature and original raised seal of a Florida Licensed Surveyor and Mapper. Additions or deletions to Survey Maps by other than the signor are prohibited without the written consent of the signing party.